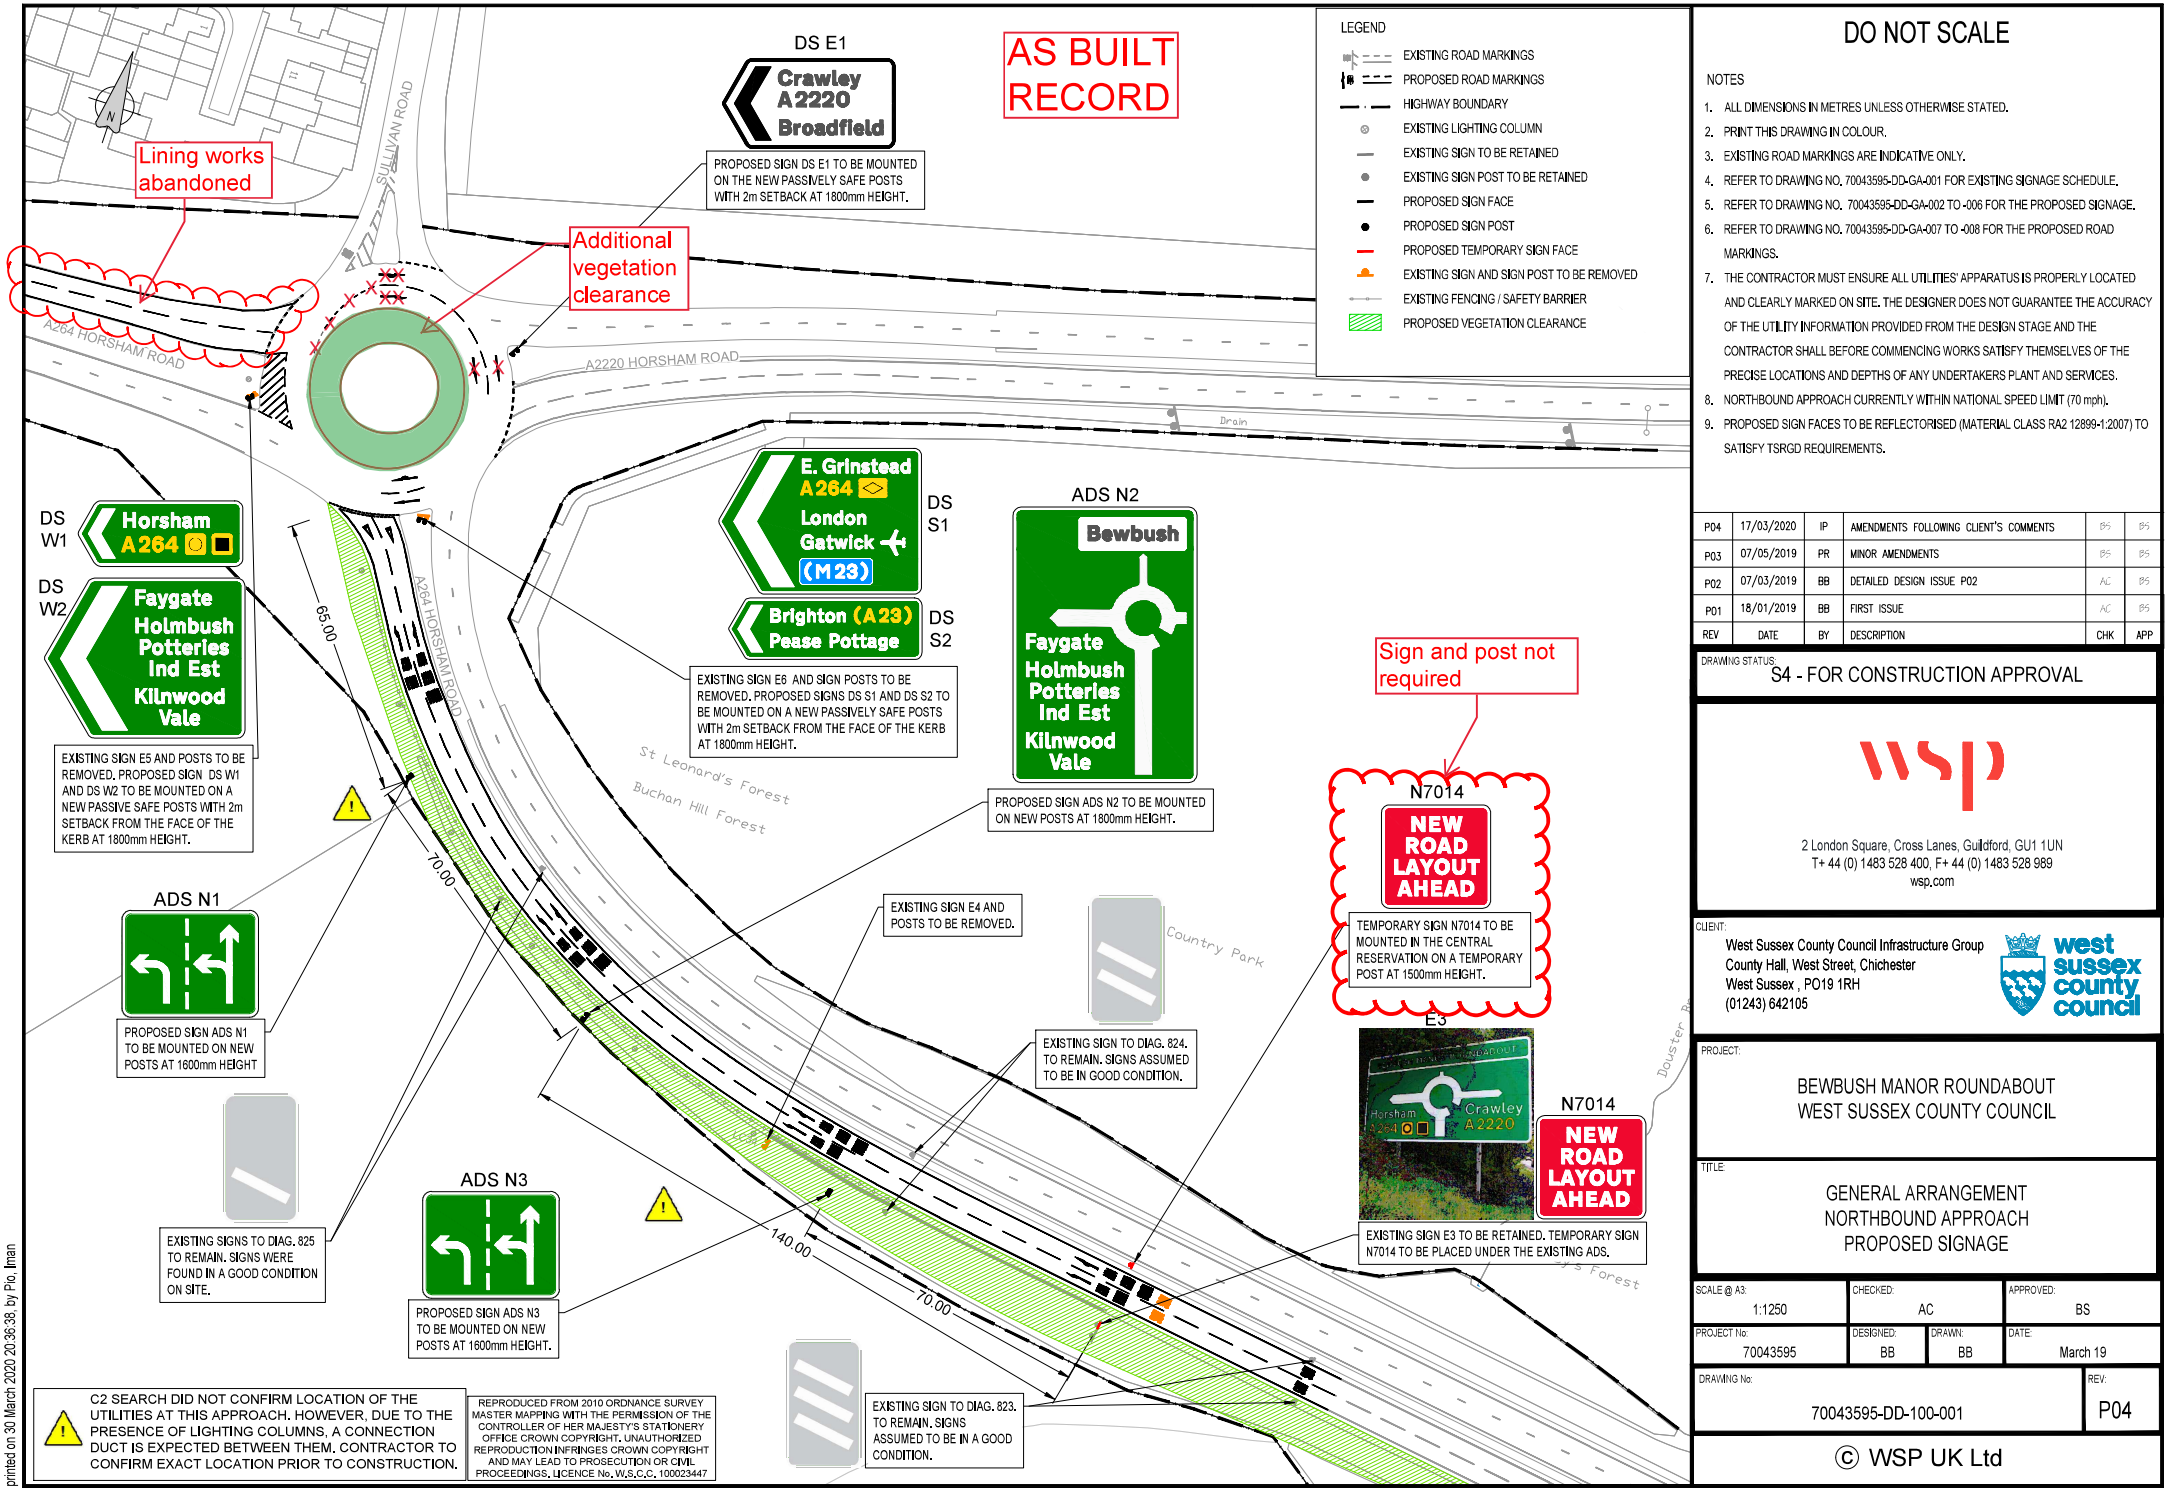

DO NOT SCALE

NOTES

1. ALL DIMENSIONS IN METRES UNLESS OTHERWISE STATED.
2. PRINT THIS DRAWING IN COLOUR.
3. EXISTING ROAD MARKINGS ARE INDICATIVE ONLY.
4. REFER TO DRAWING NO. 70043595-DD-GA-001 FOR EXISTING SIGNAGE SCHEDULE.
5. REFER TO DRAWING NO. 70043595-DD-GA-002 TO -006 FOR THE PROPOSED SIGNAGE.
6. REFER TO DRAWING NO. 70043595-DD-GA-007 TO -008 FOR THE PROPOSED ROAD MARKINGS.
7. THE CONTRACTOR MUST ENSURE ALL UTILITIES' APPARATUS IS PROPERLY LOCATED AND CLEARLY MARKED ON SITE. THE DESIGNER DOES NOT GUARANTEE THE ACCURACY OF THE UTILITY INFORMATION PROVIDED FROM THE DESIGN STAGE AND THE CONTRACTOR SHALL BEFORE COMMENCING WORKS SATISFY THEMSELVES OF THE PRECISE LOCATIONS AND DEPTHS OF ANY UNDERTAKERS PLANT AND SERVICES.
8. NORTHBOUND APPROACH CURRENTLY WITHIN NATIONAL SPEED LIMIT (70 mph).
9. PROPOSED SIGN FACES TO BE REFLECTORISED (MATERIAL CLASS RA2 12899-1:2007) TO SATISFY TSRGD REQUIREMENTS.

REV	DATE	BY	DESCRIPTION	CHK	APP
P04	17/03/2020	IP	AMENDMENTS FOLLOWING CLIENT'S COMMENTS	BS	BS
P03	07/05/2019	PR	MINOR AMENDMENTS	BS	BS
P02	07/03/2019	BB	DETAILED DESIGN ISSUE P02	AC	BS
P01	18/01/2019	BB	FIRST ISSUE	AC	BS

DRAWING STATUS:
S4 - FOR CONSTRUCTION APPROVAL

wsp
2 London Square, Cross Lanes, Guildford, GU1 1UN
T+ 44 (0) 1483 528 400, F+ 44 (0) 1483 528 989
wsp.com

CLIENT:
West Sussex County Council Infrastructure Group
County Hall, West Street, Chichester
West Sussex , PO19 1RH
(01243) 642105

PROJECT:
BEWBUSH MANOR ROUNDABOUT
WEST SUSSEX COUNTY COUNCIL

TITLE:
GENERAL ARRANGEMENT
NORTHBOUND APPROACH
PROPOSED SIGNAGE

SCALE @ A3:	CHECKED:	APPROVED:
1:1250	AC	BS

PROJECT No:	DESIGNED:	DRAWN:	DATE:
70043595	BB	BB	March 19

DRAWING No: 70043595-DD-100-001
REV: P04

© WSP UK Ltd

File name \\UK.WSPGROUP.COM\CENTRAL DATA\PROJECTS\70099\XX\70099101 - YEAR 1 WSCC MASTER PROJECT\D DESIGN AND ANALYSIS\HIGHWAYS\BEWBUSH MANOR RBT\02 WIP\HW HIGHWAYS\02 DRAWING\003 DETAIL DESIGN\ACAD\70043595-DD-100-001-P04.DWG, printed on 30 March 2020 20:36:38, by Pio, Iman